

EQUIP. TYPE *R390A/LRR* EXP. NO. _____

COL. 540 7596 002


NOTICE: WHEN GOVERNMENT DRAWINGS, SPECIFICATIONS, OR OTHER DATA ARE USED FOR ANY PURPOSE OTHER THAN IN CONNECTION WITH A DEFINITELY RELATED GOVERNMENT PROCUREMENT OPERATION, THE UNITED STATES GOVERNMENT THEREBY INCURS NO RESPONSIBILITY FOR ANY OBLIGATION WHATSOEVER AND THE FACT THAT THE GOVERNMENT MAY HAVE FORMULATED, PROMULGATED, OR IN ANY WAY SUPPLIED THE SAID DRAWINGS, SPECIFICATIONS, OR OTHER DATA IS NOT TO BE REGARDED BY INVENTION OR OTHERWISE AS IN ANY MANNER LICENSES THE HOLDER OR ANY OTHER PERSON OR CORPORATION, OR CONVEYING ANY RIGHTS OR PERMISSION TO REPRODUCE, TRANSMIT, VISE, OR SELL ANY PATENTED INVENTION THAT MAY IN ANY WAY BE RELATED THEREBY.

THIS DOCUMENT HAS BEEN PURCHASED BY THE GOVERNMENT AND MAY BE REPRODUCED AND USED IN CONNECTION WITH ANY GOVERNMENT PROCUREMENT OR MAINTENANCE OPERATION.

* FOR INFORMATION ONLY. CONTRACTOR MAY AT HIS OPTION DEVIATE FROM THESE PROCESS DETAILS.

~~* SWE APPROVAL~~
~~SYM PR10042-B~~

REVISIONS			
SYM	DESCRIPTION	DATE	APPROVAL
A ₂	A ₁ 12 WAS 10 ¹³ / ₁₆ A ₂ NOTE 1 WAS SEMIRIGID GLASS INSULATION MAT'L	27 OCT. 59	42428 PC 59-A1-51 REV'D PME

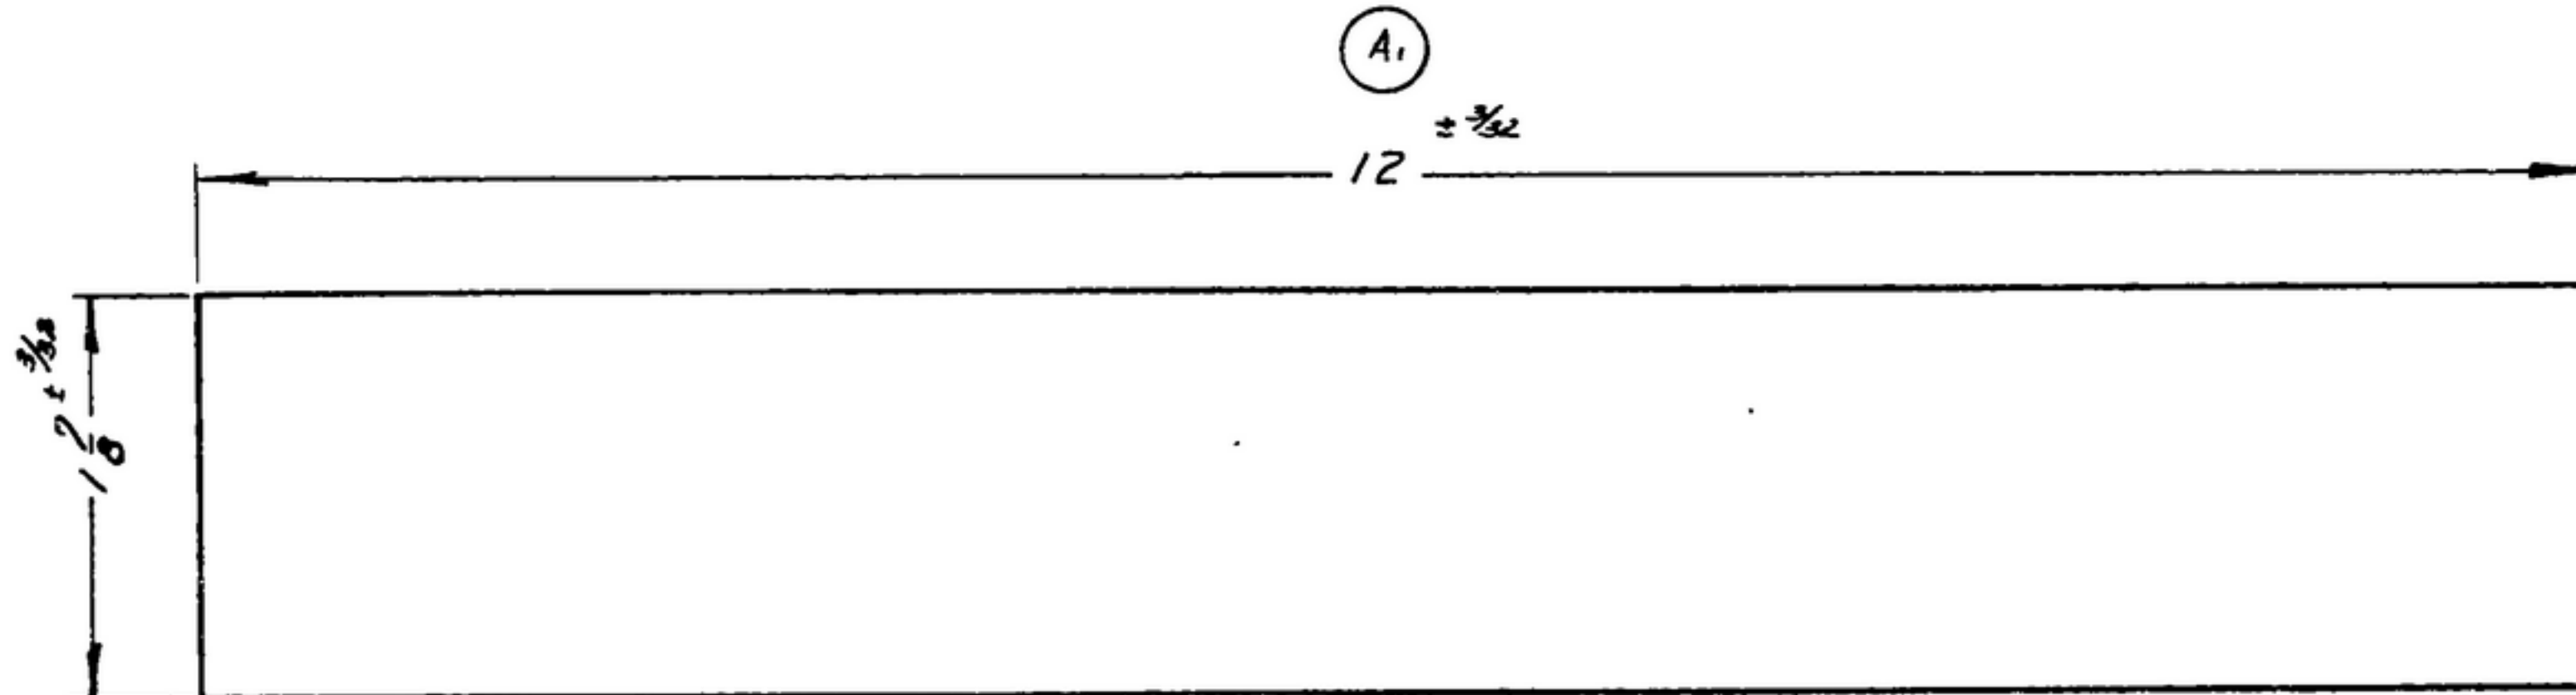

NOTES:

- (A₂) 1. ULTRALITE 1/4 # 200 (2 LB) UNFACED GLASS FIBER INSULATION MAT'L, 1/4 THK.
SUPPLIED BY GUSTIN-BACON MFG CO, 210 W. 10TH ST KANSAS CITY MISSOURI, OR EQUAL.

COLLINS PART NO.	ITEM	QTY	PART NO.	DESCRIPTION	MATL	MATL SPEC
LIST OF MATERIAL						
-COLLINS PART NO. 558-0383-002						

DRAWN <i>ECS</i>		CHECKED <i>AM</i>		APPROVED		-COLLINS RADIO CO. -CEDAR RAPIDS, IOWA- 14214 - PH - 51 - 93		DEPARTMENT OF THE ARMY SIGNAL CORPS ENGINEERING LABORATORIES FORT MONMOUTH NEW JERSEY SM-B-249033	
UNLESS OTHERWISE SPECIFIED: DECIMAL DIMENSIONS INCLUDING HOLE SIZES MAY VARY ±.008 FRACTIONAL DIMENSIONS INCLUDING HOLE SIZES MAY VARY ±1/64 MACHINED ANGLES MAY VARY ±.1° SHEARED ANGLES MAY VARY ±.25° BROKEN ANGLES MAY VARY ±.1° ECCENTRICITY BETWEEN ANY DIAMETERS ON THE SAME CENTERLINE SHALL NOT EXCEED .010 TOTAL INDICATOR READING. ALL DIMENSIONS ARE FINISH DIMENSIONS INCLUDING APPLIED FINISH AND ARE GIVEN IN INCHES.						SIGNAL CORPS			
558-0395-003 / SM-C-249045 SC-DL-248775						REVIEWED <i>PME</i>			
COLLINS NO. QTY NEXT ASSY USED ON						APPROVED <i>HLV</i> <i>PME</i>			
APPLICATION						DATE <i>16 DEC 55</i>		SCALE <i>1/1</i>	