

50

COL 367-0710-00

EQUIP. TYPE *R590A/URP* EXP. NO.


NOTICE: WHEN GOVERNMENT DRAWINGS, SPECIFICATIONS, OR OTHER DATA ARE USED FOR ANY PURPOSE OTHER THAN IN CONNECTION WITH A DEFINITELY RELATED GOVERNMENT PROCUREMENT OPERATION, THE UNITED STATES GOVERNMENT THEREBY ASSUMES NO RESPONSIBILITY FOR ANY OBLIGATION WHATSOEVER; AND THE FACT THAT THE GOVERNMENT MAY HAVE FORMULATED, FURNISHED, OR IN ANY WAY SUPPLIED THE SAID DRAWINGS, SPECIFICATIONS, OR OTHER DATA IS NOT TO BE REGARDED BY IMPLICATION OR OTHERWISE AS IN ANY MANNER LICENSING THE HOLDER OR ANY OTHER PERSON OR CORPORATION, OR CONFERRING ANY RIGHTS OR PERMISSION TO MANUFACTURE, USE, OR SELL ANY PATENTED INVENTION THAT MAY IN ANY WAY BE RELATED THERETO.

THIS DOCUMENT HAS BEEN PREPARED BY THE GOVERNMENT AND MAY BE REPRODUCED AND USED IN CONNECTION WITH ANY GOVERNMENT PROCUREMENT OR MAINTENANCE OPERATION.

\* FOR INFORMATION ONLY. CONTRACTOR MAY AT HIS OPTION DEVIATE FROM THESE PROCESS DETAILS.

~~SWE APPROVAL~~  
~~SYM PR10042-7~~

REVISIONS			
SYM	DESCRIPTION	DATE	APPROVAL
A <sub>2</sub>	A <sub>1</sub> TYPE #140 WAS #140-D MIL-M-14 WAS MIL-P-14 A <sub>2</sub> 1/4 WAS 3/16	19 OCT 59	42428-PC-59-A1-51  REV'D PME

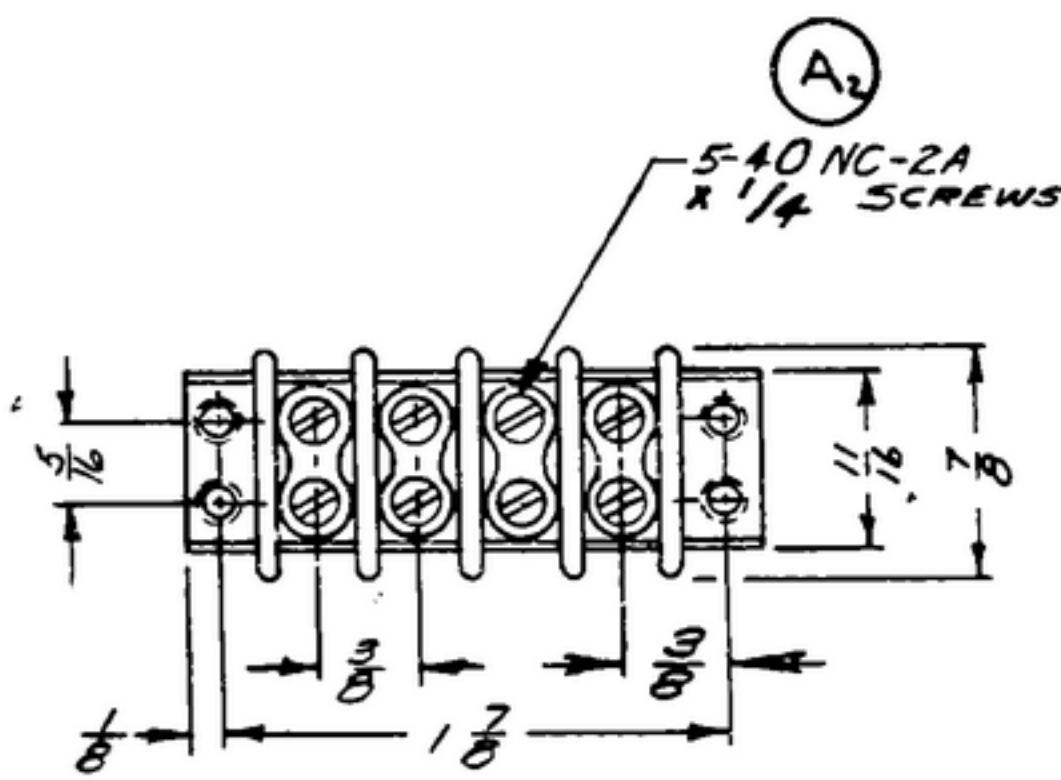

NOTES  
1. PART MAY BE TYPE #140 SUPPLIED BY HOWARD B. JONES, CHICAGO, ILL., OR EQUAL, PROVIDING IT MEETS THE FOLLOWING REQUIREMENTS AND DIMENSIONS SHOWN.

DESCRIPTION: BARRIER TYPE TERMINAL WITH LUG FOR CONNECTION.  
INSULATION: PHENOLIC RESIN TYPE C FG IN ACCORDANCE WITH SPEC MIL-M-14.  
TERMINAL AND TERMINAL SCREWS: MATERIAL BRASS  
FINISH: M312 PER SPEC MIL-F-14072.  
ALL ORGANIC MATERIALS SHALL BE FUNGUS RESISTANT, OR TREATED TO BE FUNGUS RESISTANT WITH A COATING MATERIAL IN ACCORDANCE WITH SPEC MIL-V-173, TYPE I.

COLLINE PART NO.	ITEM	REQD	PART NO.	DESCRIPTION	QTY	MAT. SPEC
LIST OF MATERIAL						
COLLINE PART NO. <i>559-0288-002</i>						

DRAWN <i>Mml</i>				CHECKED <i>Rh</i>		APPROVED		COLLINE-RADIO CO. -DESAR-RAPIDS-IOWA 1A21A-PH-51-93		DEPARTMENT OF THE ARMY SIGNAL CORPS ENGINEERING LABORATORIES  FORT MONMOUTH NEW JERSEY  <i>BOARD-TERMINAL</i>  SM-B-283187	
UNLESS OTHERWISE SPECIFIED: DECIMAL DIMENSIONS INCLUDING HOLE SIZES MAY VARY ±.008 FRACTIONAL DIMENSIONS INCLUDING HOLE SIZES MAY VARY ±1/64 MACHINED ANGLES MAY VARY ±1° SHEARED ANGLES MAY VARY ±.25° BROKEN ANGLES MAY VARY ±1° ECCENTRICITY BETWEEN ANY DIAMETERS ON THE SAME CENTERLINE SHALL NOT EXCEED .010 TOTAL INDICATOR READING. ALL DIMENSIONS ARE FINISH DIMENSIONS INCLUDING APPLIED FINISH AND ARE GIVEN IN INCHES.								SIGNAL CORPS			
558-0338-00A-1 SM-D-245984 SC-DL-248775 COLLINS NO. QTY NEXT ASSY USED ON APPLICATION								REVIEWED <i>PME</i>			
								APPROVED <i>HLV</i> <i>PME</i>			
								DATE? <i>Dec 55</i>		SCALE <i>1/1</i>	