

U.S. Naval Base, Pearl Harbor, Lualualei Radio HABS No. HI-152
Transmitting Facility
(U.S. Naval Base, Pearl Harbor, Naval Computer and
Telecommunications Area Master Station Eastern Pacific)
(Antenna Towers S-109, S-110, S-111)
Edison and Tower Drives
Pearl Harbor
Honolulu County
Hawaii

HABS
HI
2-PEHA,
25-

PHOTOGRAPHS

WRITTEN HISTORICAL AND DESCRIPTIVE DATA

Historic American Buildings Survey
National Park Service
Western Region
Department of the Interior
San Francisco, California 94107

HABS
HI
2-PEHA,
25-

HISTORIC AMERICAN BUILDING SURVEY

U.S. Naval Base, Pearl Harbor, Lualualei Radio Transmitting Facility
Antenna Towers

(U.S. Naval Computer and Telecommunications Area Master Station
Eastern Pacific)

(Antenna Towers S-109, S-110, S-111)

HABS No. H1-152

Location: Edison and Tower Drive near Transmitter Building No.1
Waianae
Honolulu County
Hawaii

USGS Pearl Harbor Quadrangle, Hawaii
7.5 minutes series (orthophotoquad)
Universal Transverse Mercator coordinates
Antenna Tower S-109 - 4.586618.2370516 (scale 1:25,000)
Antenna Tower S-110 - 4.586799.2370360 (scale 1:25,000)
Antenna Tower S-111 - 4.586560.2370260 (scale 1:25,000)

Date of Construction: 1935

Engineer: Fourteenth Naval District, Navy Yard, Pearl Harbor

Present Owner: U.S. Naval Computer and Telecommunications Area Master Station

Present Use: The antenna towers were constructed of structural steel angles and riveted connections. They are self supporting structure and stand 300 feet in height. These antenna towers have no current use and are in excess to the mission of NCTAMS EASTPAC.

Significance: Antenna Towers S-109, S-110, S-111 are uncategorized facilities located outside the Pearl Harbor National Historic Landmark. The historical significance of the towers is due to their role both during and after World War II. Initially, these antenna towers were used to maintain communication for naval shore installations and fleet units in the Eastern Pacific area. Following the war, during the mid 1940's through the late 1960's, the towers were designated as the "Voice of America" towers used to broadcast American news internationally. Original construction drawings available on microfiche at the Navy Public Works Center, Pearl Harbor, Hawaii.

Report Prepared by: Lisa A. Chan, Civil Engineer
Naval Public Works Center
Project Development Branch
Pearl Harbor, Hawaii 96860-5470

Date: January 1994

HABS No. HI-152

Page 2

Source: Microfiche - Public Works Center, Pearl Harbor, Hawaii

Antenna Tower S-109

REPAIR SCHEDULE-S109			
ITEM NO.	ITEM OF WORK	TO BE DONE	REMARKS
1	Painting of tower structure	Painting of tower structure	
2	Painting of tower structure	Painting of tower structure	
PLAN

TOWER BASE ASSEMBLY

SECTION



GRAPHIC SCALES


STEEL PLATE PATTERN & LEVEL W/D

PLAN

RECORD DRAWING

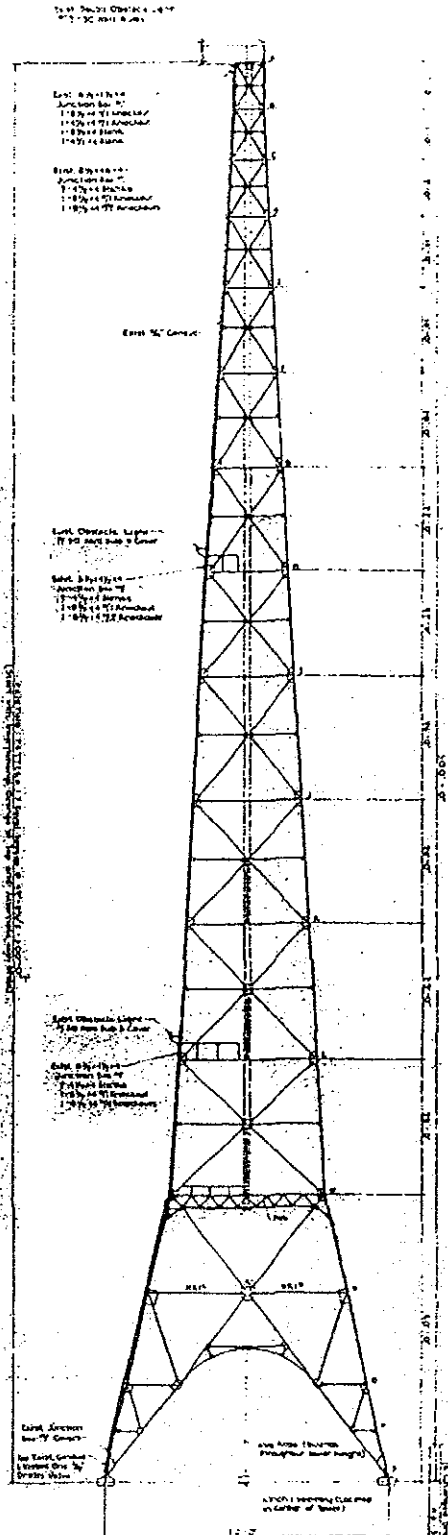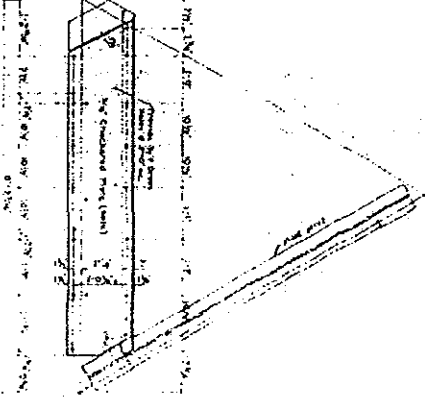


TYPICAL ELEVATION
EXISTING TOWER S109
SCALE 1/2\"/>


ORIENTATION PLAN

Antenna Tower S-110



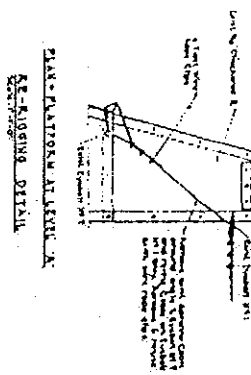



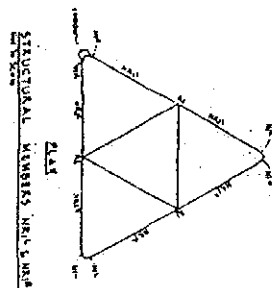


STRUCTURAL MEMBERS NR1 & NR2

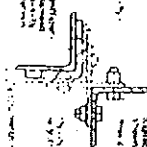

SECTION 2
RECORDS MANAGEMENT

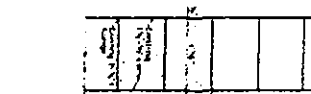

idea

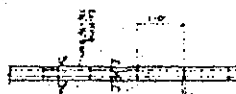



XME.F.5-C. 1077 5



INDEX



1847

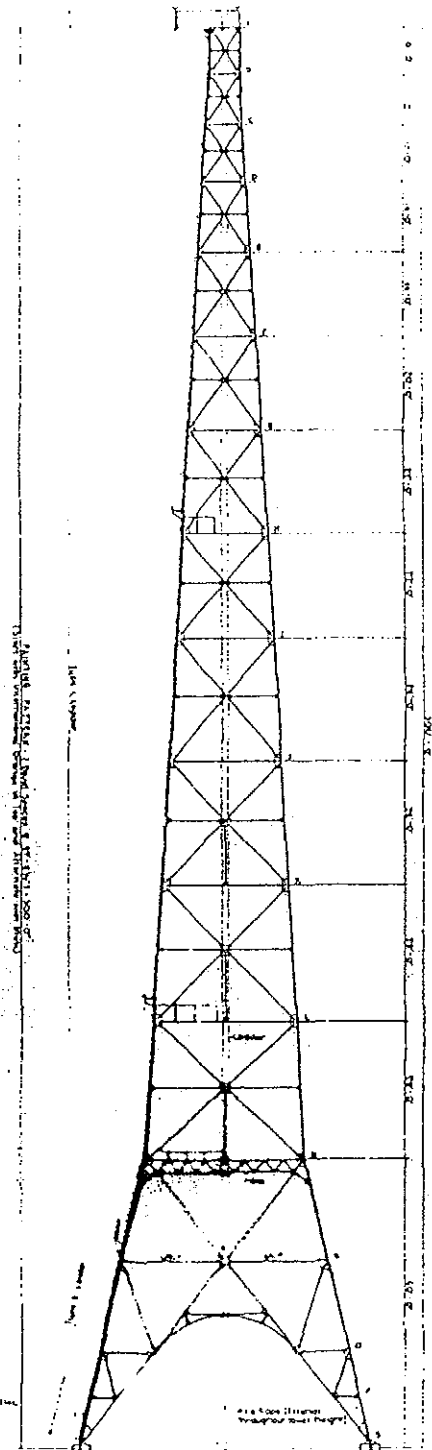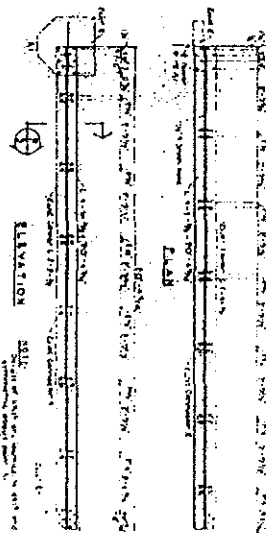

TYPICAL ELEVATION
EXISTING TOWER SHO









HABS No. HI-152

Page 4

Source: Microfiche - Public Works Center, Pearl Harbor, Hawaii

Antenna Tower S-111

REPAIR SCHEDULE - S-111			
NO.	ITEM OR WORK	TIME	REMARKS
1	Paint tower with Rust Inhibiting Primer	1 day	
2	Paint tower with Rust Inhibiting Primer	1 day	
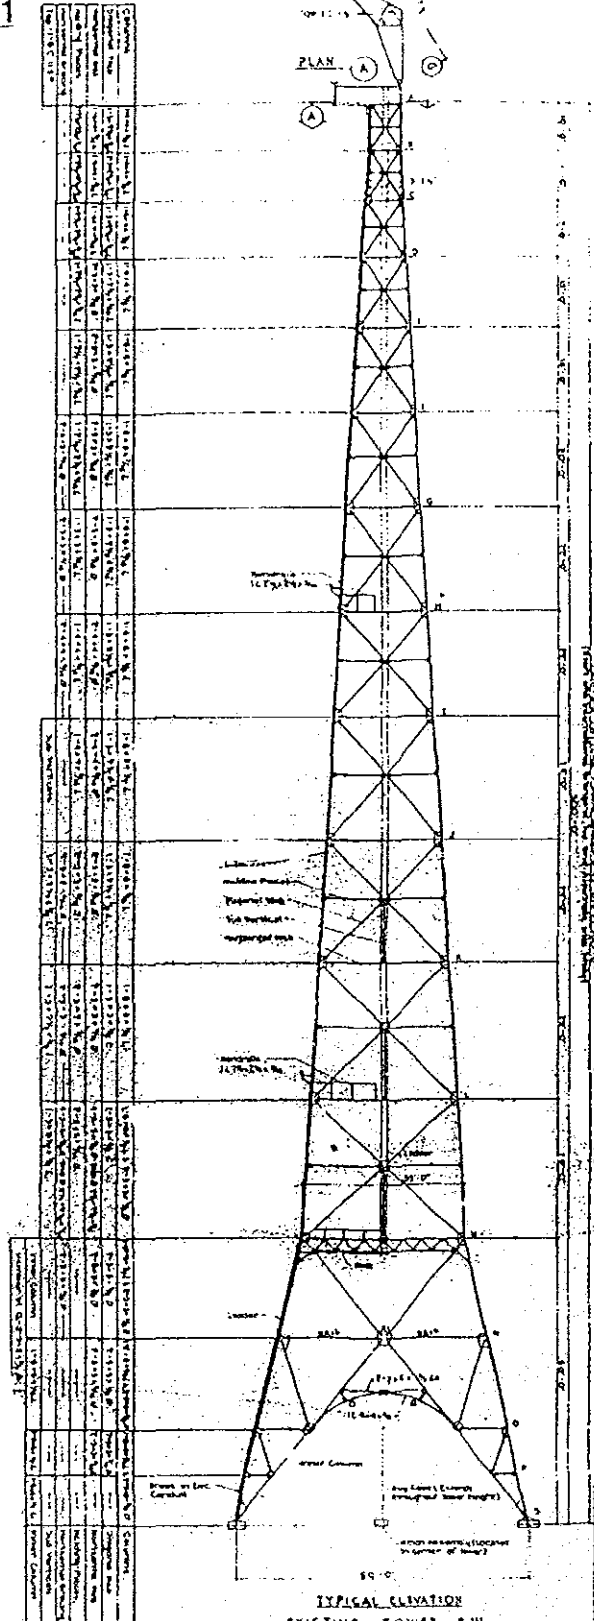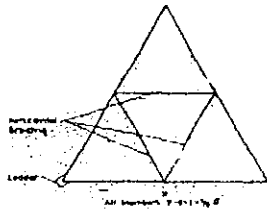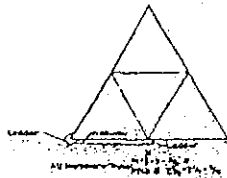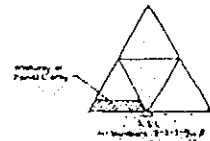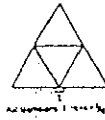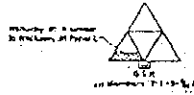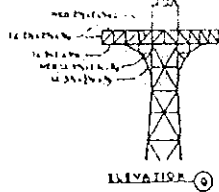


Typical Elevation
EXISTING TOWER S-111
Scale: 1" = 10'-0"

ORIENTATION PLAN

STADING SCALE

U.S. Naval Base, Pearl Harbor, Lualualei Radio Transmitting Facility
(U.S. Naval Computer and Telecommunications Area Master Station
Eastern Pacific) (Antenna Towers S-109, S-110, S-111)
HABS No. HI-152 (Page 5)

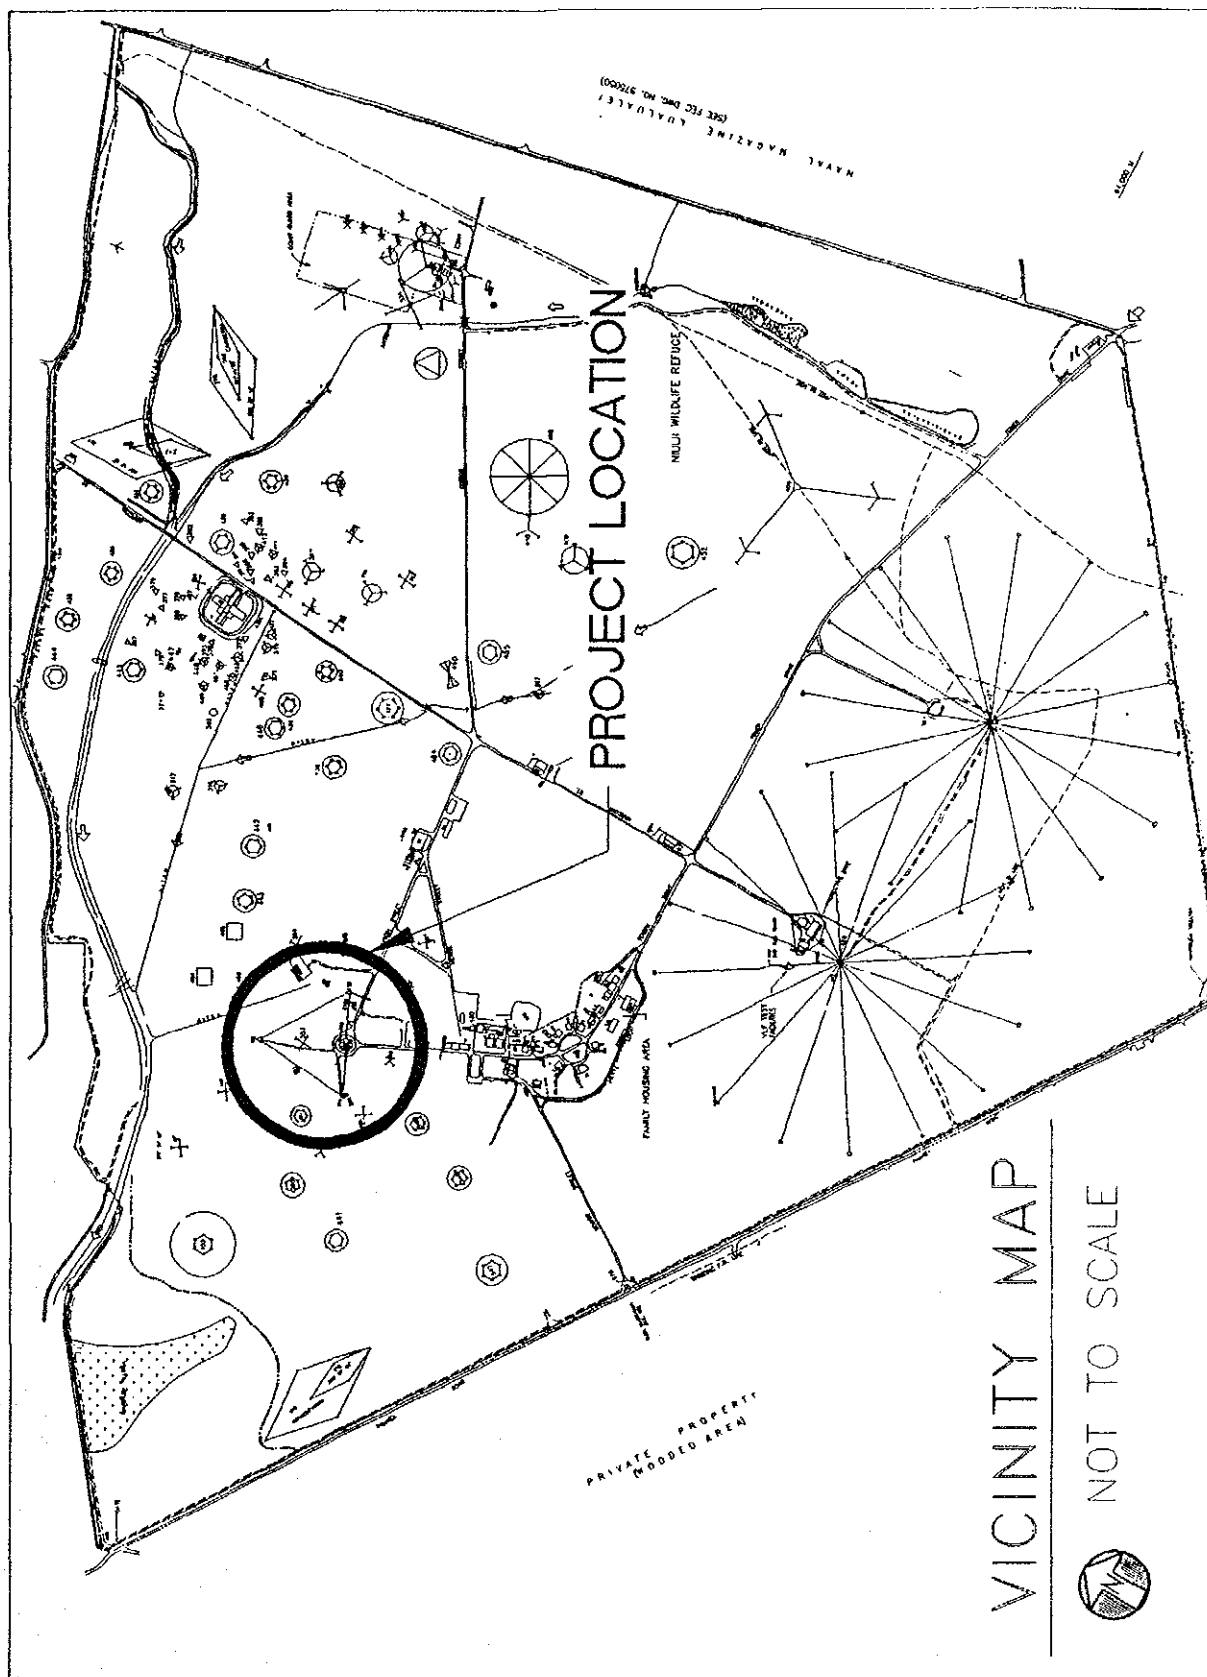

U.S. Naval Base, Pearl Harbor, Luuluolei Radio Transmitting Facility
(U.S. Naval Computer and Telecommunications Area Master Station
Eastern Pacific)(Antenna Towers S-109, S-110, S-111)
HABS No. HI-152 (Page 6)

