7

EQUIP. TYPE R390A/URR EXP. NO.

~~COL. 540 7442 002~~

NOTICE: WHEN GOVERNMENT DRAWINGS, SPECIFICATIONS, OR OTHER DATA ARE USED FOR ANY PURPOSE OTHER THAN IN CONNECTION WITH A DEFINITELY RELATED GOVERNMENT PROCUREMENT OPERATION, THE UNITED STATES GOVERNMENT THEREBY INCURS NO RESPONSIBILITY NOR ANY OBLIGATION WHATSOEVER; AND THE FACT THAT THE GOVERNMENT MAY HAVE FORMULATED, FURNISHED, OR IN ANY WAY SUPPLIED THE SAID DRAWINGS, SPECIFICATIONS, OR OTHER DATA IS NOT TO BE REGARDED BY IMPLICATION OR OTHERWISE AS IN ANY MANNER LICENSING THE HOLDER OR ANY OTHER PERSON OR CORPORATION, OR CONVEYING ANY RIGHTS OR PERMISSION TO MANUFACTURE, USE, OR SELL ANY PATENTED INVENTION THAT MAY IN ANY WAY BE RELATED THERETO.

THIS DOCUMENT HAS BEEN PURCHASED BY THE GOVERNMENT AND MAY BE REPRODUCED AND USED IN CONNECTION WITH ANY GOVERNMENT PROCUREMENT OR MAINTENANCE OPERATIONS.

*FOR INFORMATION ONLY. CONTRACTOR MAY AT HIS OPTION DEVIATE FROM THESE PROCESS DETAILS.

REVISIONS			
SYM	DESCRIPTION	DATE	APPROVAL
A	A_1 - ADDED NEW APPLICATION SM-C-343598 & SM-C-343595	27 JAN. 60	42428-PC-59 REV'D
B	B_1 - .2495 $\pm$ .0005 DIA. WAS .249 $\pm$ .001 DIA.	16 OCT. 60	42428-PC-59 REV'D. PME

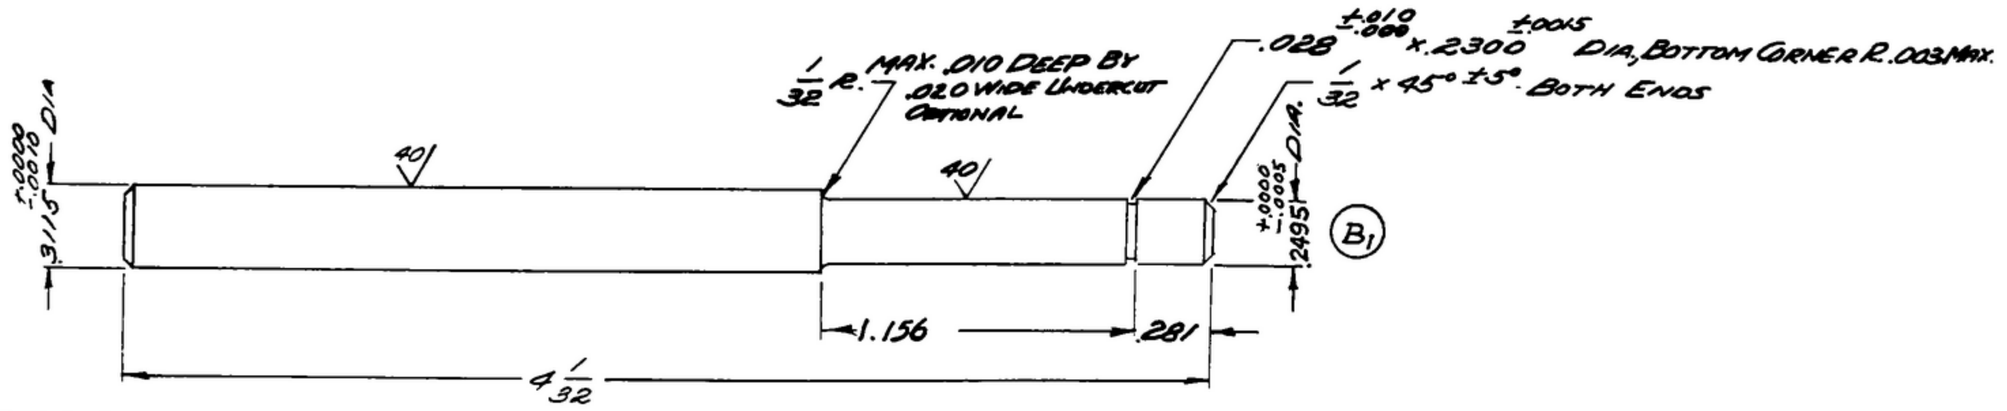

CRES, COMP. 303S, COND. B, SURFACE COND'd, PER SPEC MIL-S-7720

FINISH: E300 PER SPEC. MIL-F-14072.
~~* COLLINS 580 002500.~~

NOTES:
1. PART SHALL BE FREE OF BURRS & SHARP EDGES.
2. CENTER DRILL OPTIONAL.

~~COLLINS PART NO.~~	ITEM	NOMD	PART NO.	DESCRIPTION	MAT'L	MAT'L SPEC

LIST OF MATERIAL ~~COLLINS PART NO. 558 0230 002~~

~~COLLINS NO.~~	~~QTY~~	NEXT ASSY	USED ON
		SM-C-343598	
		SM-C-343597	
~~558 0309 003~~	+	SM-C-248960	
~~558 0310 003~~	+	SM-C-248961	SC-DL-248775

APPLICATION

DRAWN Mml | CHECKED Williams | APPROVED

UNLESS OTHERWISE SPECIFIED:
- DECIMAL DIMENSIONS INCLUDING HOLE SIZES MAY VARY ±.005
- FRACTIONAL DIMENSIONS INCLUDING HOLE SIZES MAY VARY ±1/64
- MACHINED ANGLES MAY VARY ±.1°
- SHEARED ANGLES MAY VARY ±.25°
- BROKEN ANGLES MAY VARY ±1.°
- ECCENTRICITY BETWEEN ANY DIAMETERS ON THE SAME CENTERLINE SHALL NOT EXCEED .010 TOTAL INDICATOR READING.
- ALL DIMENSIONS ARE FINISH DIMENSIONS INCLUDING APPLIED FINISH AND ARE GIVEN IN INCHES.

~~COLLINS RADIO CO. CEDAR RAPIDS, IOWA~~
14214-PH-51-93

SIGNAL CORPS

REVIEWED PME

APPROVED HLY PME

DATE 8 Dec 55

SHAFT-TUNING

SCALE 2/1

DEPARTMENT OF THE ARMY
SIGNAL CORPS ENGINEERING LABORATORIES
FORT MONMOUTH NEW JERSEY

SM-B-248881