Col. 546-7933-003

EQUIP. TYPE R-390A/URR EXP. NO.

NOTICE: WHEN GOVERNMENT DRAWINGS, SPECIFICATIONS, OR OTHER DATA ARE USED FOR ANY PURPOSE OTHER THAN IN CONNECTION WITH A DEFINITELY RELATED GOVERNMENT PROCUREMENT OPERATION, THE UNITED STATES GOVERNMENT THEREBY INCURS NO RESPONSIBILITY NOR ANY OBLIGATION WHATSOEVER; AND THE FACT THAT THE GOVERNMENT MAY HAVE FORMULATED, FURNISHED, OR IN ANY WAY SUPPLIED THE SAID DRAWINGS, SPECIFICATIONS, OR OTHER DATA IS NOT TO BE CONSIDERED BY GIVING LICENSE OR IN ANY OTHER MANNER.

THIS DOCUMENT HAS BEEN PURCHASED BY THE GOVERNMENT AND MAY BE REPRODUCED AND USED IN CONNECTION WITH ANY GOVERNMENT PROCUREMENT OR CONTEMPLATED APPLICATION

*FOR INFORMATION ONLY. CONTRACTOR MAY AT HIS OPTION DEVIATE FROM THESE PROCESS DETAILS.

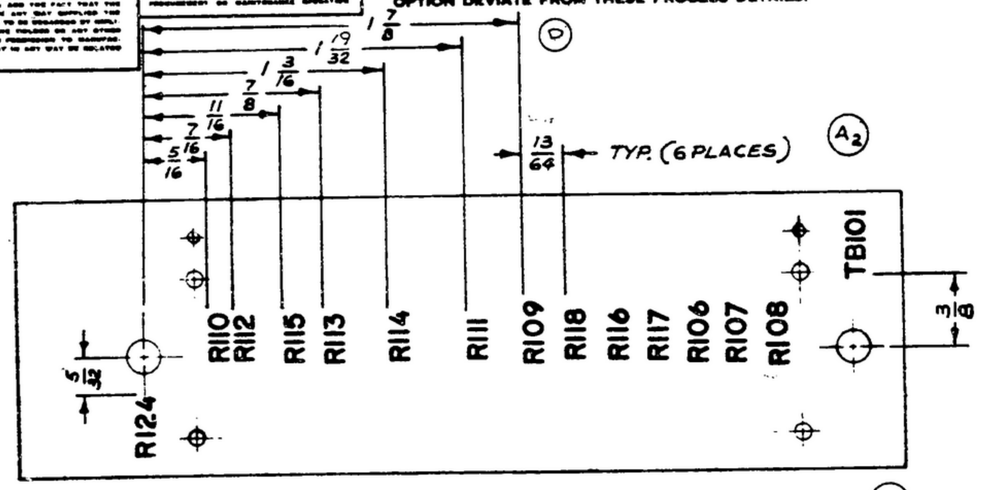

SWE APPROVAL	
SYM	PR10042-10
B1	CA 84821

SYM	DESCRIPTION	DATE	APPROVAL
A4	A1-TYPE FLEG. ETC WAS PER DWG. SM-B-283225. A2-NOTE 2 WAS "SILK SCREENING TO BE BLACK LOCATED AS SHOWN, MARKING SHALL MEET THE TEST REQUIREMENTS OF SPEC. MIL-M-13231." A3-REMOVED SILK SCREEN NOTATION AND ITEM 3 (SM-B-248809). A4-REMOVED NOTE 3.	6 NOV. 59	42428-PC-59-A1-51 REV'D. PME
B1	B1-NOTE 3 ADDED.	29 JUNE 60	42428-PC-59 REV'D. PME
C1	(1) WAS .650	23 MAR 1965	21582-PC-61 REVD PME
D1	D 1 7/32 WAS 1 5/32.	12 MAY 66	6-00189 REV'D CC-2
E1	E1 .650 WAS .550	31 MAY 67	6-00189 REVD CC-3

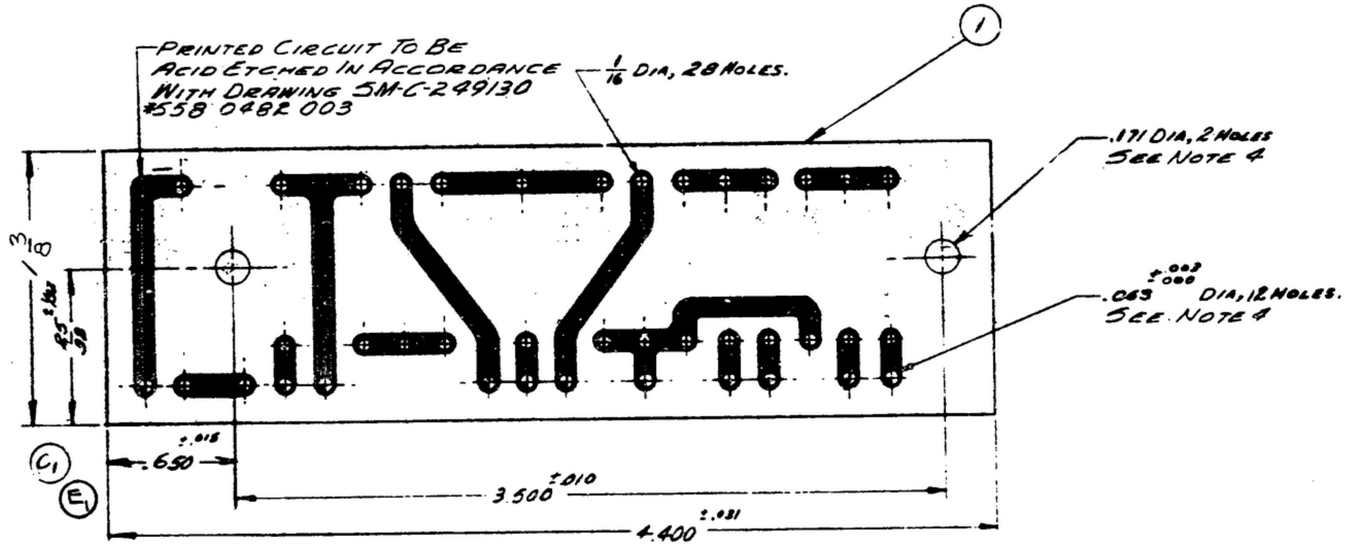

NOTES:

A1 1. MATERIAL TO BE COPPER CLAD GLASS CLOTH LAMINATE TYPE FLEG .062 CU2B PER MIL-P-21466.

A4 2. ALL CHARACTER TO BE 3/32 HIGH GOTHIC TYPE PER SPEC. MIL-M-13231, GROUP II, COLOR TO BE BLACK, COLOR CHIP #27038 PER FED STD. 595. COVER DESIGNATIONS WITH 1 COAT OF VARNISH, MIL-V-173 TYPE II.

B1 3. FINISH: BRIGHT ALLOY PLATE PER ALBALLOY PROCESS BY HANSON-VAN WINKLE-MUNNING CO. MATAWAN, N.J., OR EQUAL.

4. ALL HOLES TO BE SPOTTED AFTER ETCHING.

5. THE MASTER OF THE PRINTED WIRING MP1063 WILL BE SUPPLIED BY U.S. ARMY SIGNAL MATERIEL SUPPORT AGENCY, FORT MONMOUTH, NEW JERSEY, ATTN: SIGMS-PPX. UPON REQUEST BY THE CONTRACTOR.

A3

COLLINS PART NO.	ITEM	USED	PART NO.	DESCRIPTION	MAT'L	MAT'L SPEC	NOTE
~~558 0482 003~~	2	Ref	SM-C-249130	CIRCUIT-PANEL, BOARD			
~~559 0877 002~~	1	1	SM-C-249125-1	BOARD			

LIST OF MATERIAL COLLINS PART NO. ~~558 0477 003~~

COLLINS PART NO.	ITEM	USED	NEXT ASSY	USED ON
558 0464 003	1	SM-C-249112	SC-DL-248775	

APPLICATION

DRAWN Hamer | CHECKED Ham | APPROVED

UNLESS OTHERWISE SPECIFIED:
DECIMAL DIMENSIONS INCLUDING HOLE SIZES MAY VARY ±.005
FRACTIONAL DIMENSIONS INCLUDING HOLE SIZES MAY VARY ±1/64
MACHINED ANGLES MAY VARY ±1°
SHEARED ANGLES MAY VARY ±2½°
BROKEN ANGLES MAY VARY ±1°
CONCENTRICITY BETWEEN ANY DIAMETERS ON THE SAME CENTERLINE SHALL NOT EXCEED .005 TOTAL INDICATOR READING.
ALL DIMENSIONS ARE FINISH DIMENSIONS INCLUDING APPLIED FINISH AND ARE GIVEN IN INCHES.

COLLINS RADIO CO. CEDAR RAPIDS, IOWA
14214-PH-51-93
SIGNAL CORPS
REVIEWED PME
APPROVED H-Y PME
DATE 3 JAN 56

BOARD-CIRCUIT

DEPARTMENT OF THE ARMY
SIGNAL CORPS ENGINEERING LABORATORIES
FORT MONMOUTH NEW JERSEY
SM-C-249125

WHEN REFERRING TO THIS STATE DRAWING NO.